


SHEET NO. 101

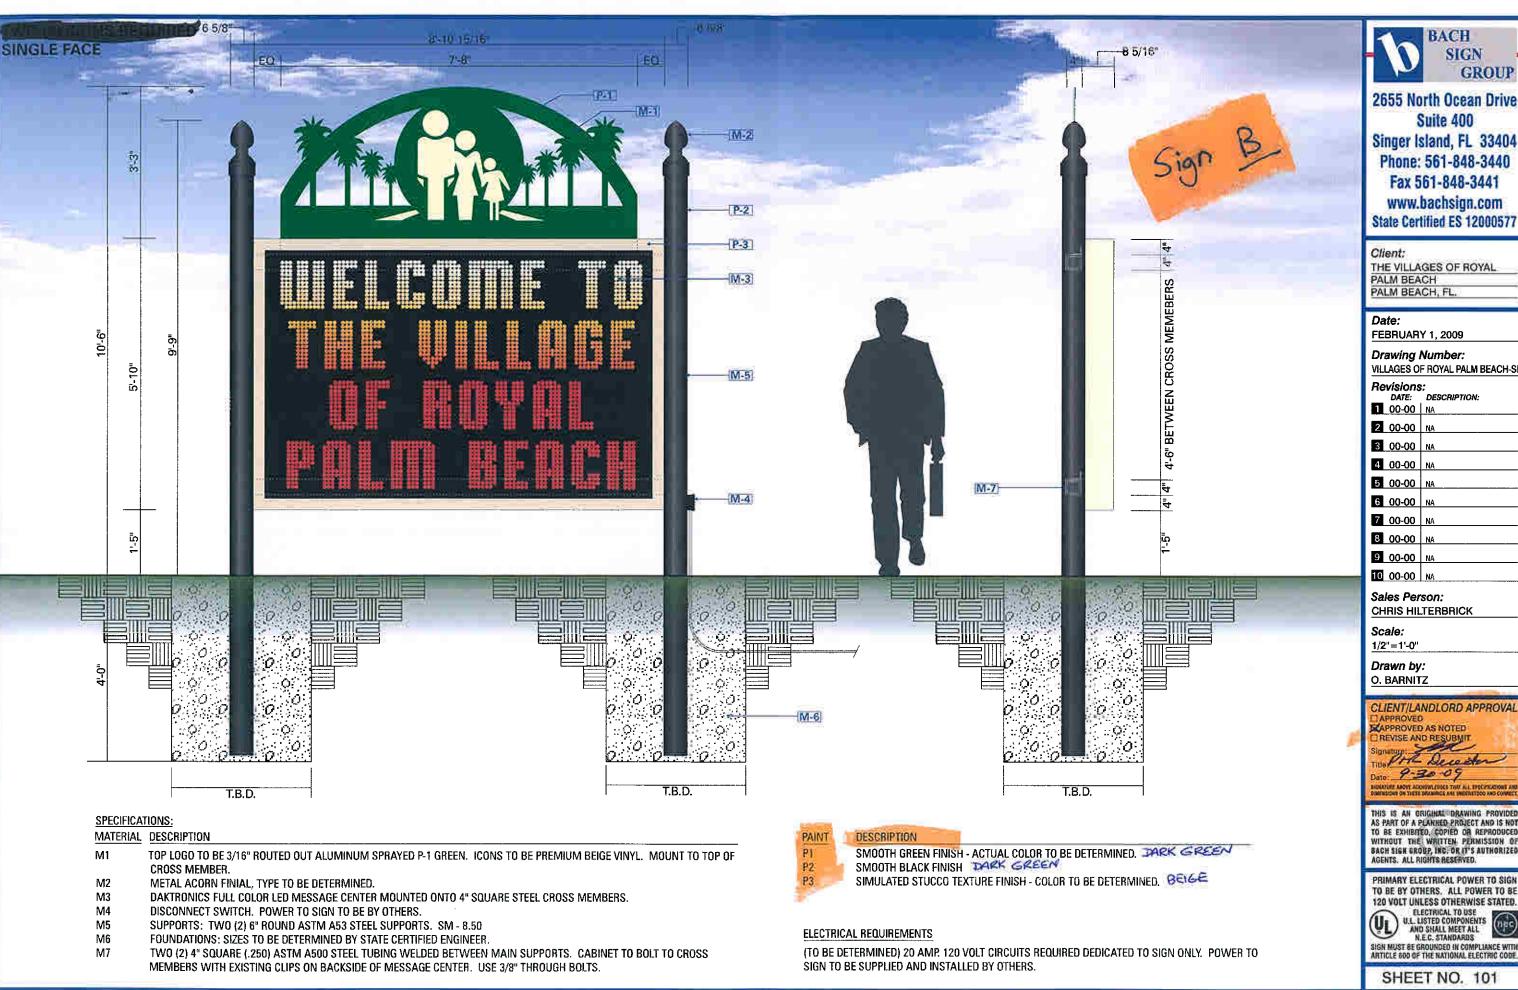

BACH SIGN GROUP

2655 North Ocean Drive Suite 400 Singer Island, FL 33404 Phone: 561-848-3440 Fax 561-848-3441 www.bachsign.com

THE VILLAGES OF ROYAL PALM BEACH PALM BEACH, FL

FEBRUARY 1, 2009

Drawing Number:

VILLAGES OF ROYAL PALM BEACH-SF

Revisions: _______DATE: DESCRIPTION:

- 2 00-00 3 00-00
- 4 00-00
- 6 00-00
- 9 00-00 NA
- 10 00-00 NA

Sales Person: **CHRIS HILTERBRICK**

O. BARNITZ

CLIENT/LANDLORD APPROVAL APPROVED AS NOTED REVISE AND RESUBMIT

9-30-09


THIS IS AN ORIGINAL DRAWING PROVIDED AS PART OF A PLANNED PROJECT AND IS NOT TO BE EXHIBITED, COPIED OR REPRODUCED WITHOUT THE WRITTEN PERMISSION OF BACH SIGH GROUP, INC. OR IT'S AUTHORIZED AGENTS. ALL RIGHTS RESERVED.

PRIMARY ELECTRICAL POWER TO SIGN TO BE BY OTHERS. ALL POWER TO BE 120 VOLT UNLESS OTHERWISE STATED.



ELECTRICAL TO USE U.L. LISTED COMPONENTS AND SHALL MEET ALL N.E.C. STANDARDS

SIGN MUST BE GROUNDED IN COMPLIANCE WITH ARTICLE 600 OF THE NATIONAL ELECTRIC CODE.

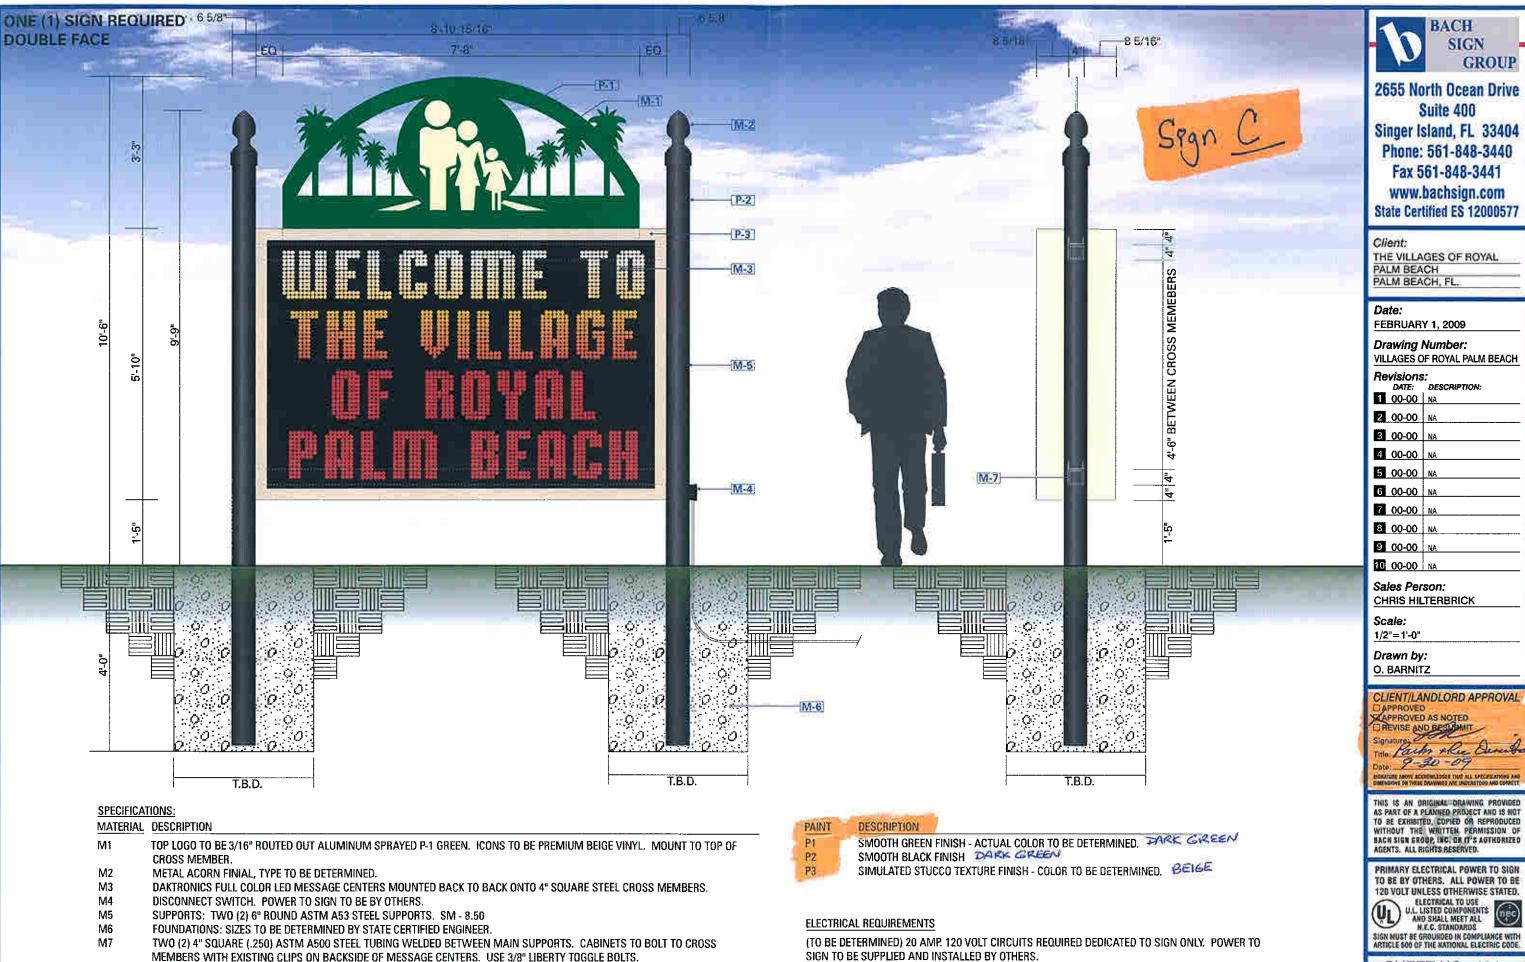

SHEET NO. 101

SIGN

GROUP